


1,680 Square Feet

Paramount Office Center  
 1141 Montlimar Drive  
 Suite 3012

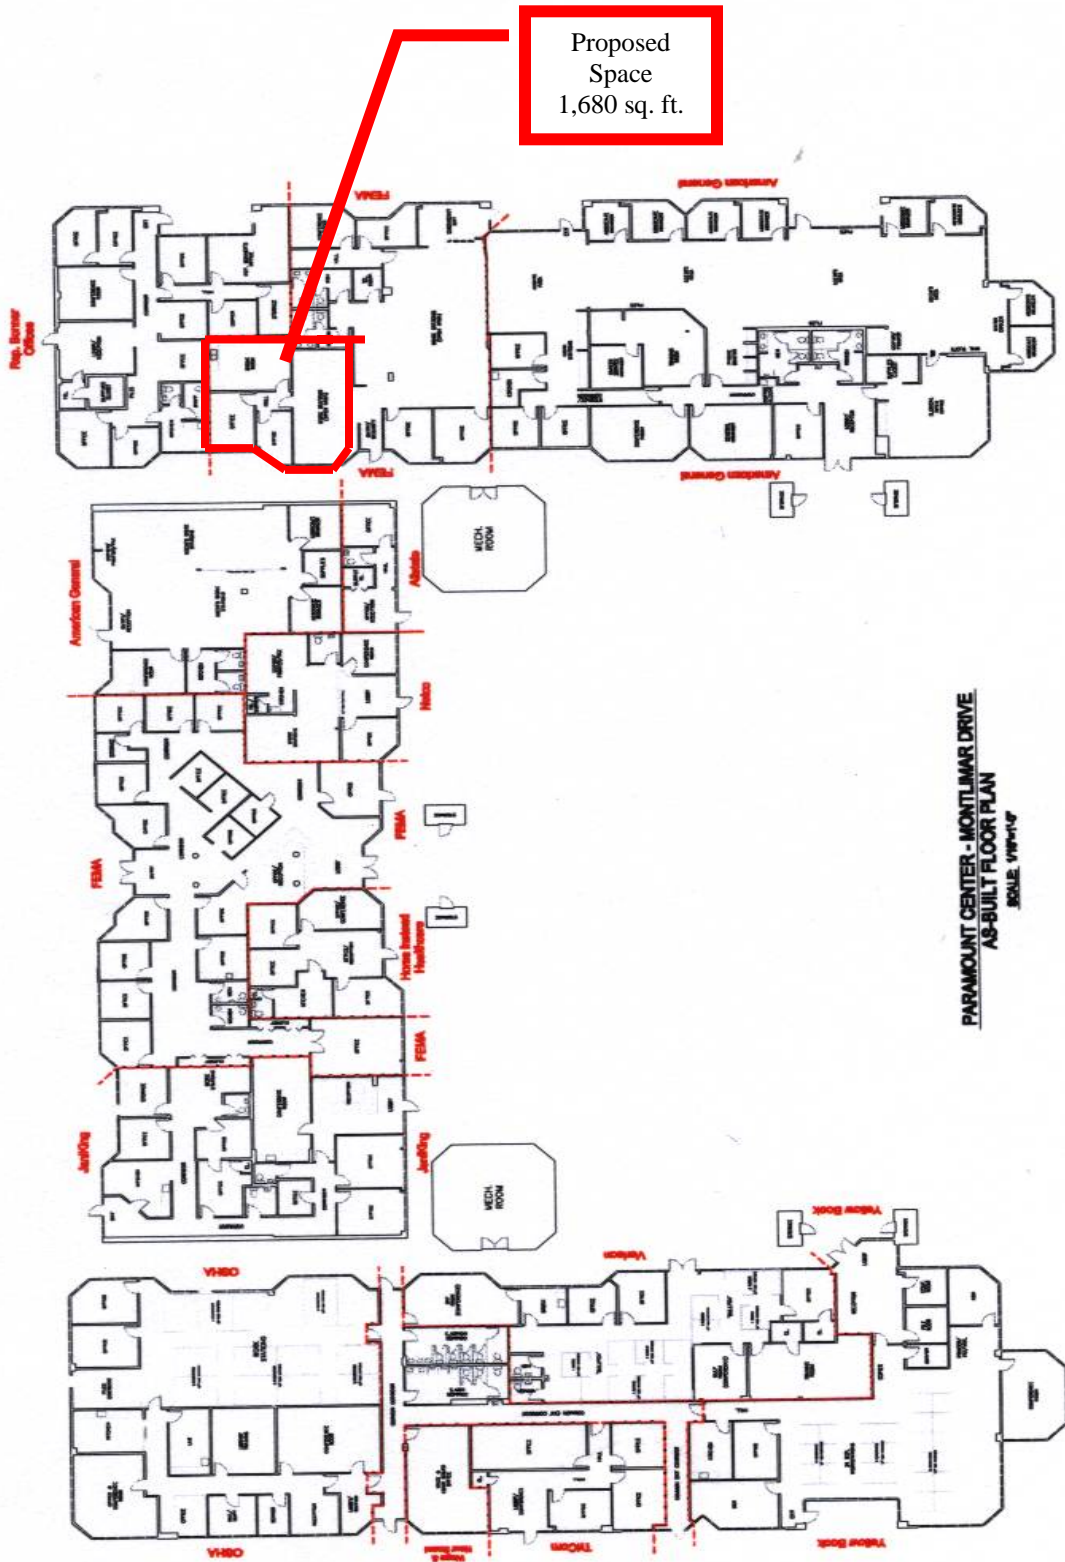

Proposed  
Space  
1,680 sq. ft.

**PARAMOUNT CENTER - MONTLAMAR DRIVE**  
AS-BUILT FLOOR PLAN  
SCALE: 1/8"=1'-0"